



Copyright (C) Tesla Blue Planet s.r.o. 2023 All Rights Reserved. Copying & sharing is prohibited without written permission. Data in the material used may be subject to change.

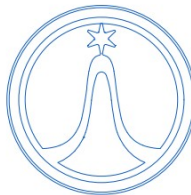


#### LEGEND:

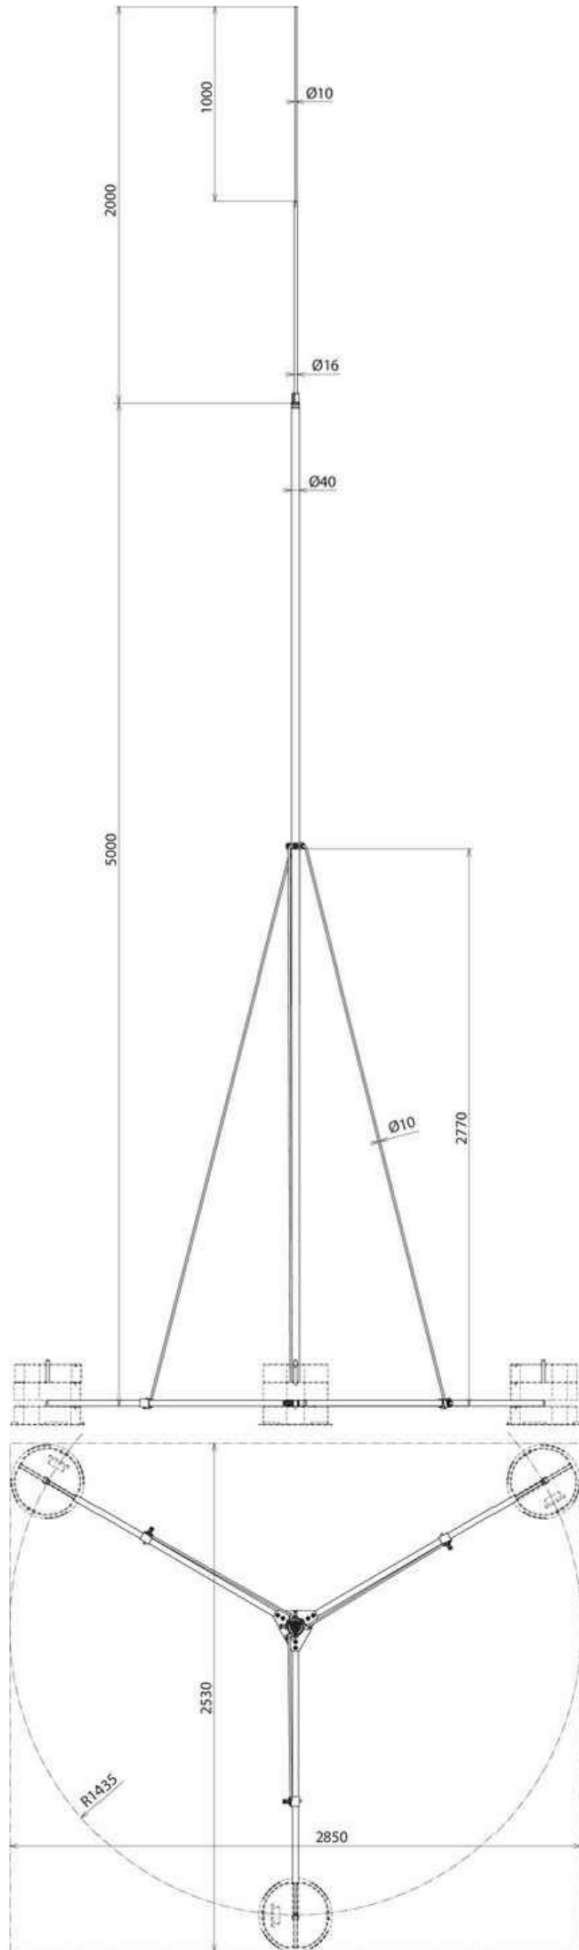

Lightning rods DEHN FS  
D40 16 10 7000 AL DBS KB STTZN  
(with 6 bases) h: 7000mm

#### LIGHTNING ROD - EARTHING CONNECTION DETAIL

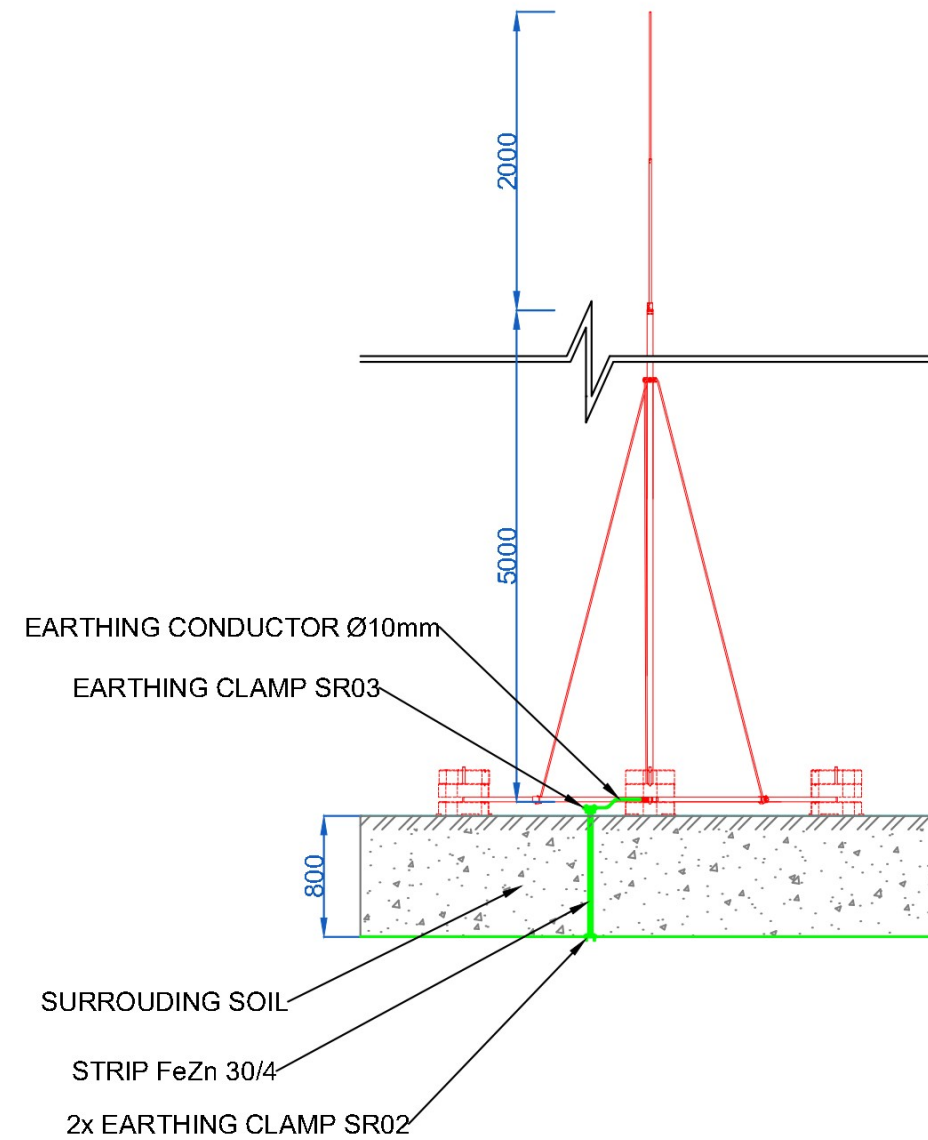

#### PROJECT NAME

**BESS Steenwijkerland**

LOCATION Wanneperveen, Netherlands FINAL CLIENT Zonnepark Steenwijkerland B.V.

DOCUMENTATION LEVEL As built DESIGNER TESLA Blue Planet s.r.o.

PART S001 MAIN SUPPLIER TESLA Blue Planet s.r.o.

DRAWING NAME Lightning rod - Detail

#### PROJECT NUMBER

NL-2023-043

#### HEAD DESIGNER

#### RESPONSIBLE DESIGNER

#### APPROVED BY

#### CREATED BY

#### DATE

03.2024

#### REVISION

0

#### SCALE

A3

#### FORMAT

#### DRAWING NUMBER

13.03