



Copyright (C) Tesla Blue Planet s.r.o. 2023 All Rights Reserved. Copying & sharing is prohibited without written permission. Data in the material used may be subject to change.

- LEGEND:
- Earthing conductor outgoing
 - Joint in the earth SR02
 - Lightning rods DEHN FS D40 16 10 7000 AL DBS KB STTZN (with 6 bases) h: 7000mm

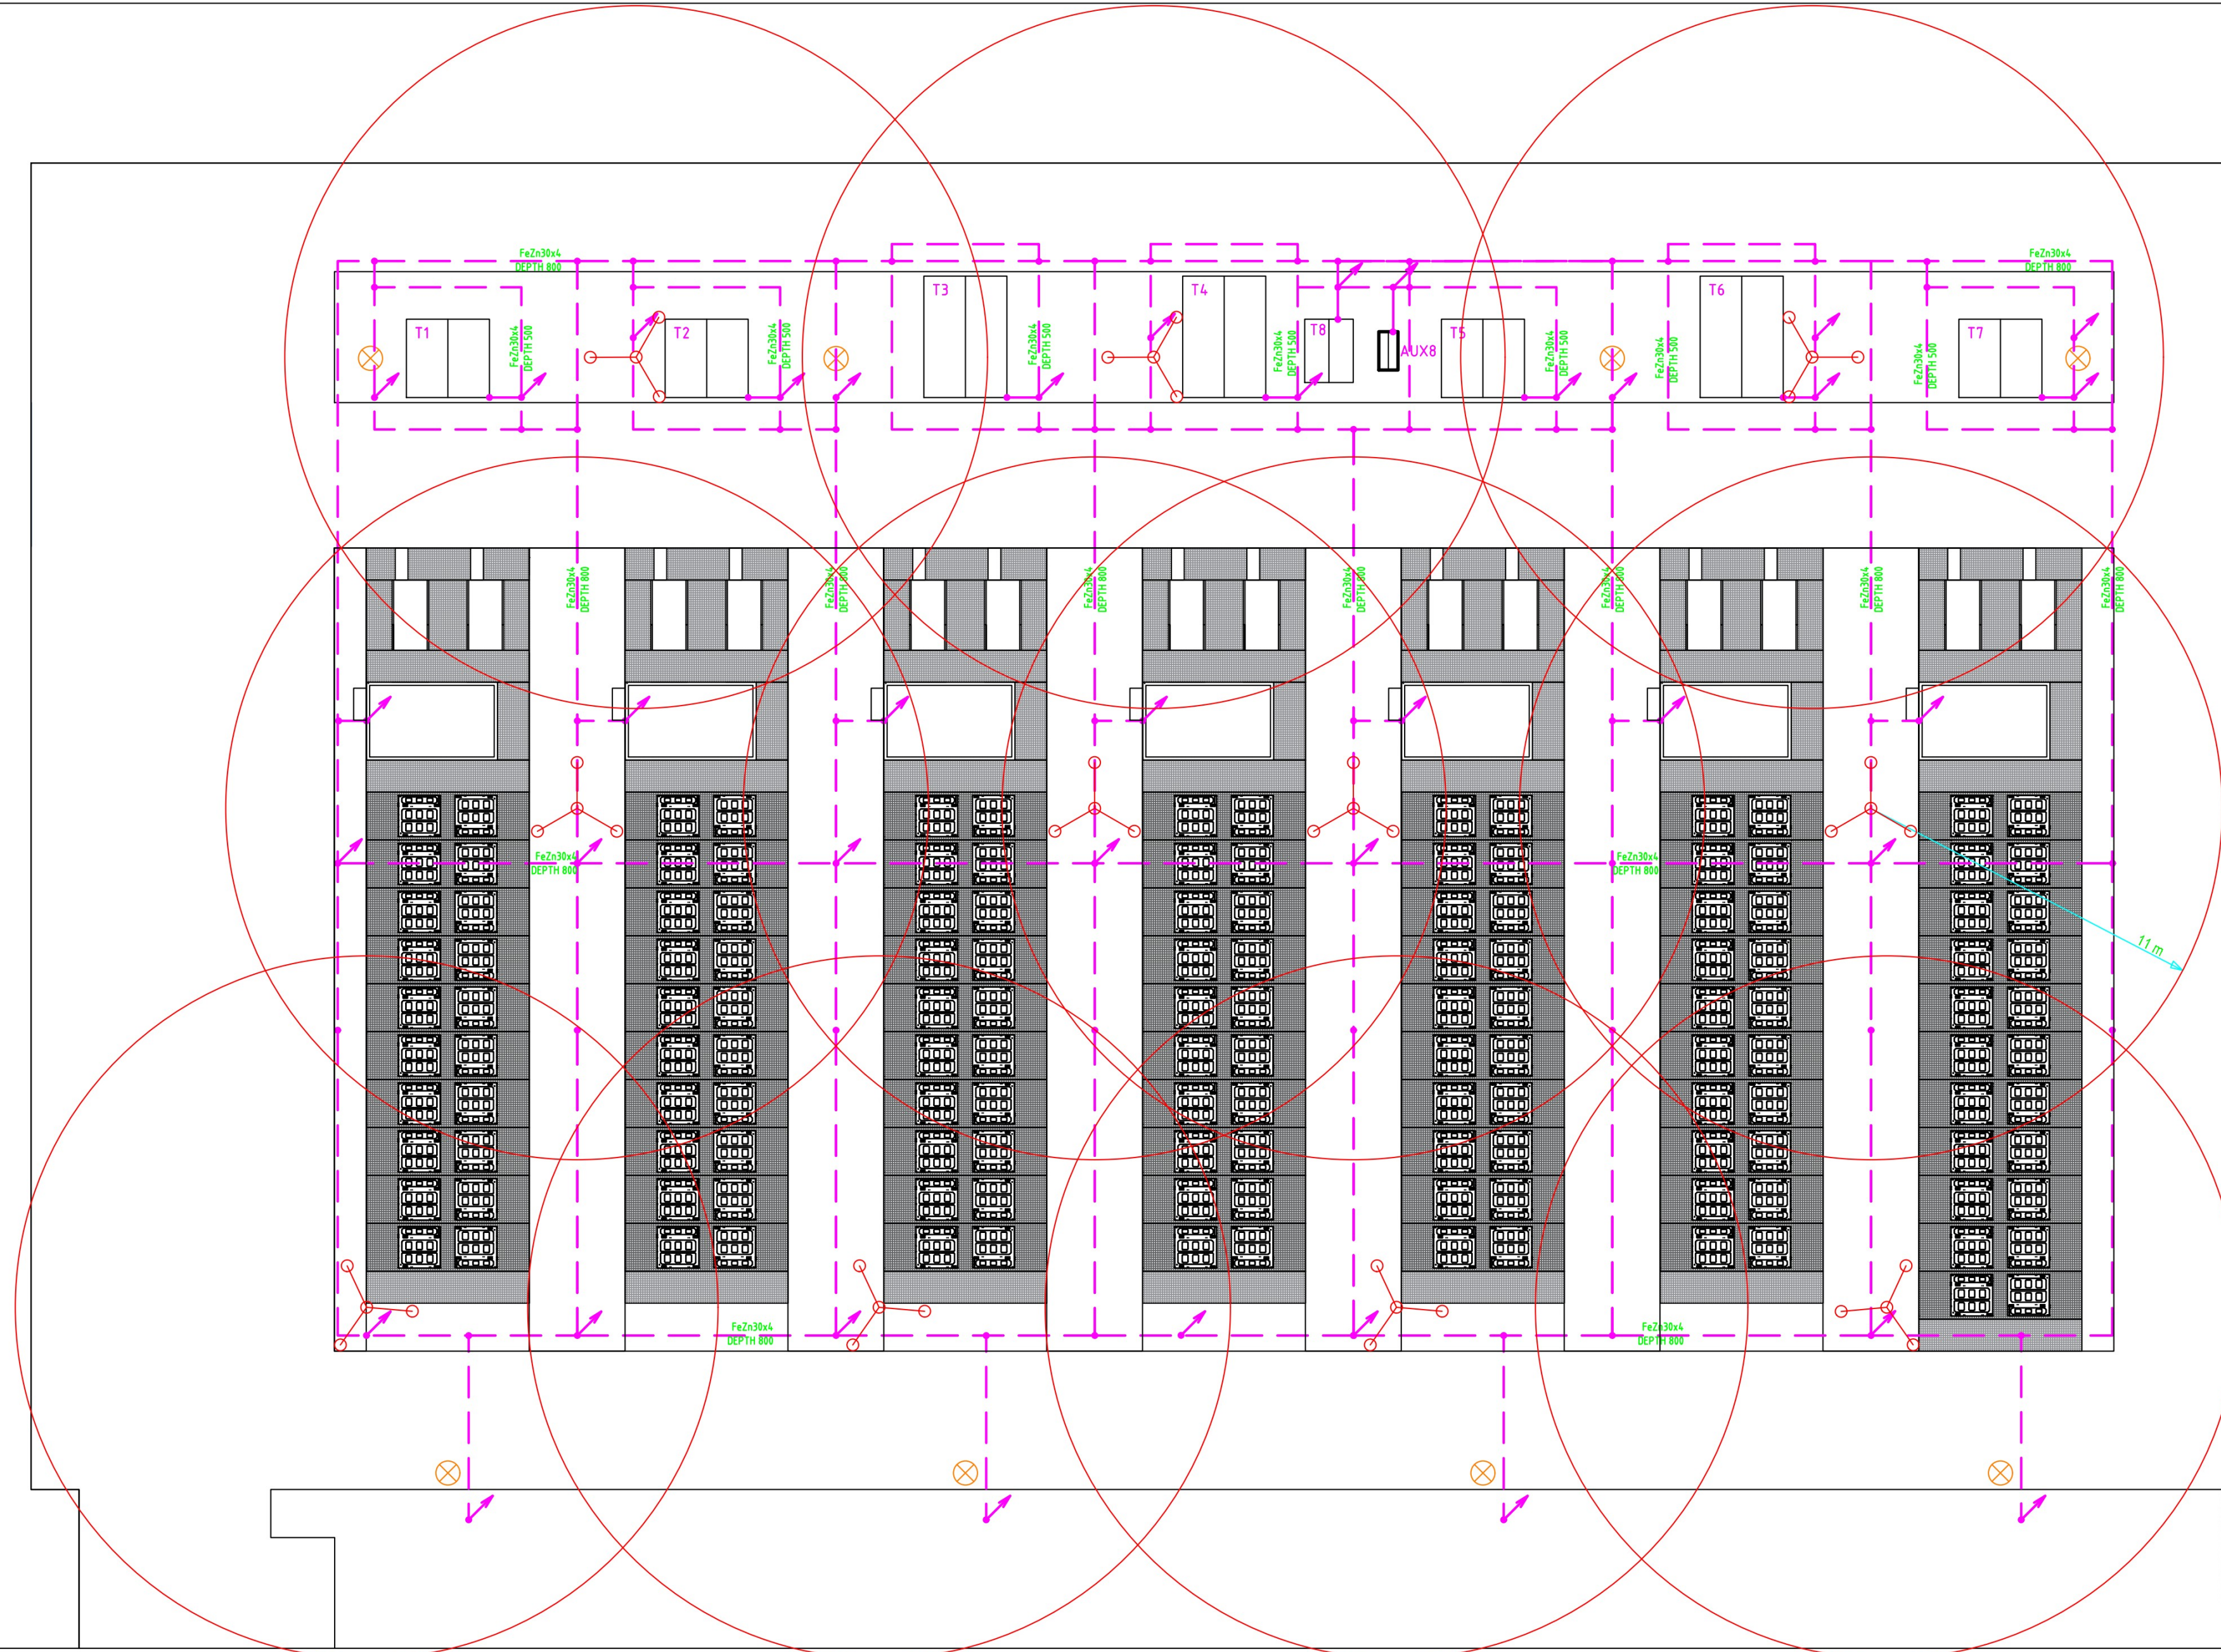

NOTES:
ANTICORR. PROT. OF EARTH. CONDUCTOR 30 cm (UNDER TERRAIN) - 20 cm (ABOVE) EACH JOINT IN THE EARTH TO PROTECT BY ANTICORR. TAPE

BASIC PARAMETERS:
LIGHTNING PROT. LEVEL (LPL): II
LIGHTNING PROT. SYSTEM (LPS): II
METHOD OF LPS: PROTECTIVE ANGLE ACCEPT.
DISTANCE S: 0.30 M
EARTHING TYPE: B
EARTHING RESIST. OF LPS: < 10 OHM

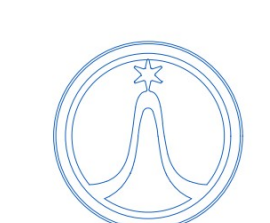

PROJECT NAME		PROJECT NUMBER	NL-2023-043
LOCATION		HEAD DESIGNER	
Wanneperveen, Netherlands		RESPONSIBLE DESIGNER	
DOCUMENTATION LEVEL		APPROVED BY	
As built		CREATED BY	
PART		DATE	03.2024
SO01		REVISION	0
DRAWING NAME		SCALE	1:150
LPS and Grounding		FORMAT	A2
		DRAWING NUMBER	13